

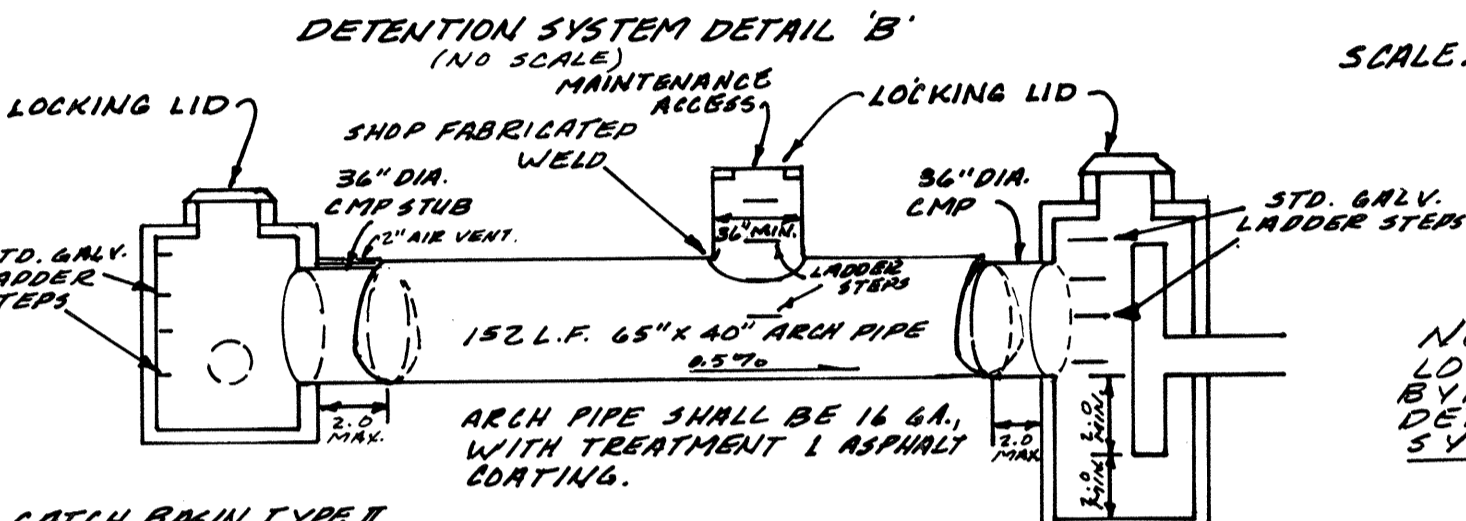


GENERAL NOTES

1. ALL WORK AND MATERIALS SHALL BE IN ACCORDANCE WITH SNOHOMISH COUNTY STANDARDS AND SPECIFICATIONS.
2. ALL LOCATIONS OF EXISTING UTILITIES SHOWN ARE APPROXIMATE AND IT SHALL BE THE RESPONSIBILITY OF THE CONTRACTOR TO VERIFY THE EXACT LOCATIONS TO AVOID DAMAGE OR DISTURBANCE.
3. ALL INLET AND CATCH BASIN FRAMES AND GRATES SHALL NOT BE ADJUSTED UNTIL IMMEDIATELY PRIOR TO PAVING.
4. ALL REQUIRED STORM WATER RETENTION/DETENTION FACILITIES MUST BE CONSTRUCTED AND IN OPERATION PRIOR TO ANY PAVING UNLESS OTHERWISE APPROVED BY THE DEPT. OF PUBLIC WORKS.
5. DRAINAGE STRUCTURES NOT ON PUBLIC RIGHT-OF-WAY SHALL HAVE LOCKING LIDS.
6. ALL DISTURBED SURFACES SHALL BE SEEDED WITH TOWN HAWK, EAST GROWING, GRASS UNLESS LANDSCAPING/EROSION CONTROL MEASURES ARE EMPLOYED.
7. PRIOR TO ANY SITE WORK PERTAINING TO DRAINAGE, THE CONTRACTOR SHALL CONTACT THE FIELD COORDINATOR FOR PLATS, UTILITIES, DRAINAGE @ 25' SPACING TO SET UP SCHEDULING. A 3' BUILT SHALL BE PROVIDED BY THE ENGINEER.
8. PRIOR TO SIDEWALK CONSTRUCTION, THE ENGINEER WILL EVALUATE INDIVIDUAL LOT DRAINAGE AND DIRECT THE INSTALLATION OF CATCH BASIN STUBS AND PERF. PIPE AS REQUIRED. LOCATIONS OF THESE INSTALLATIONS SHALL BE PLACED ON THE AS-BUILT CONSTRUCTION PLANS AND SUBMITTED TO THE COUNTY.
9. ALL FILLS SHALL BE COMPACTED TO MIN. OF 95% OF MAXIMUM DENSITY.

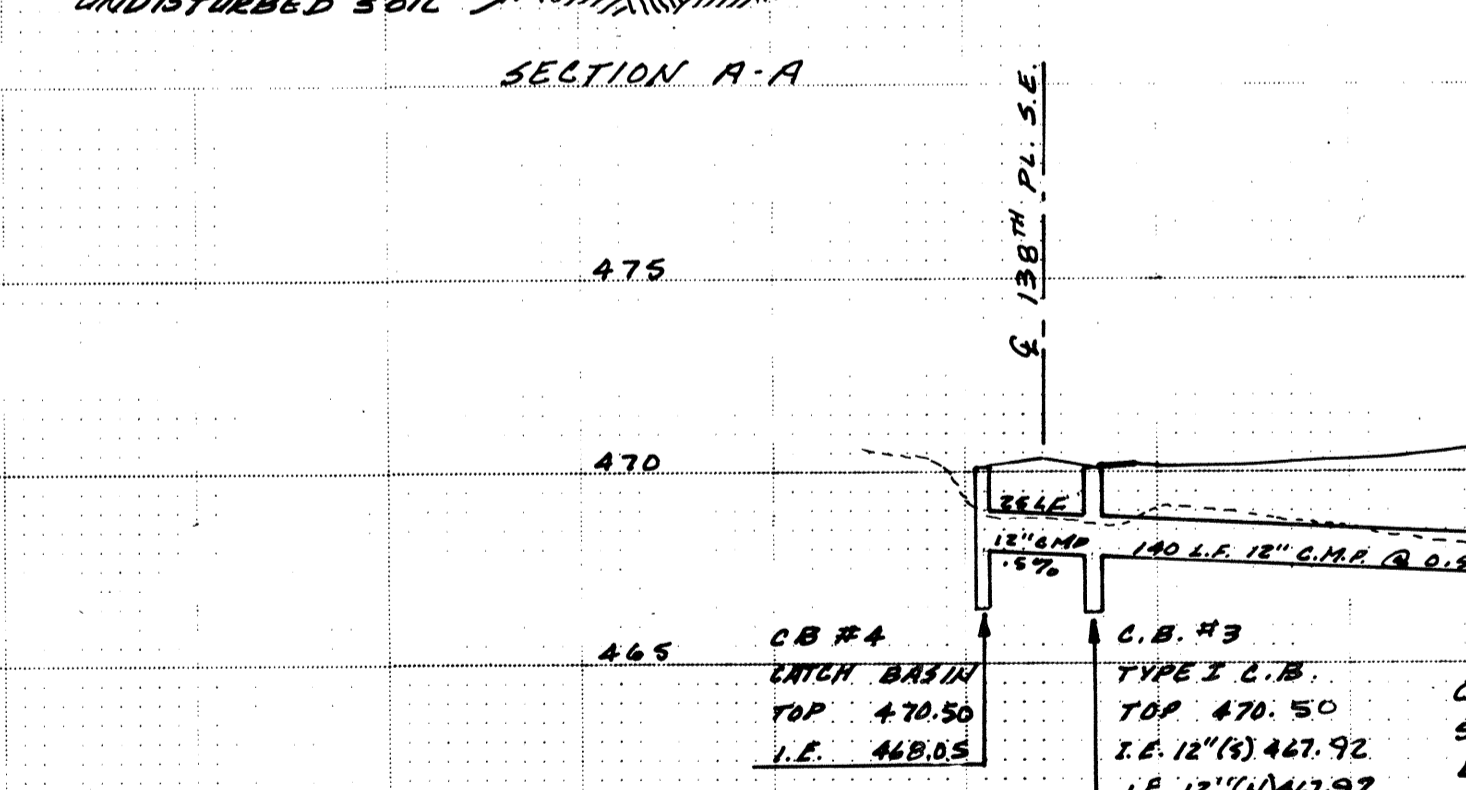

CATCH BASIN TYPE II 54\"/>


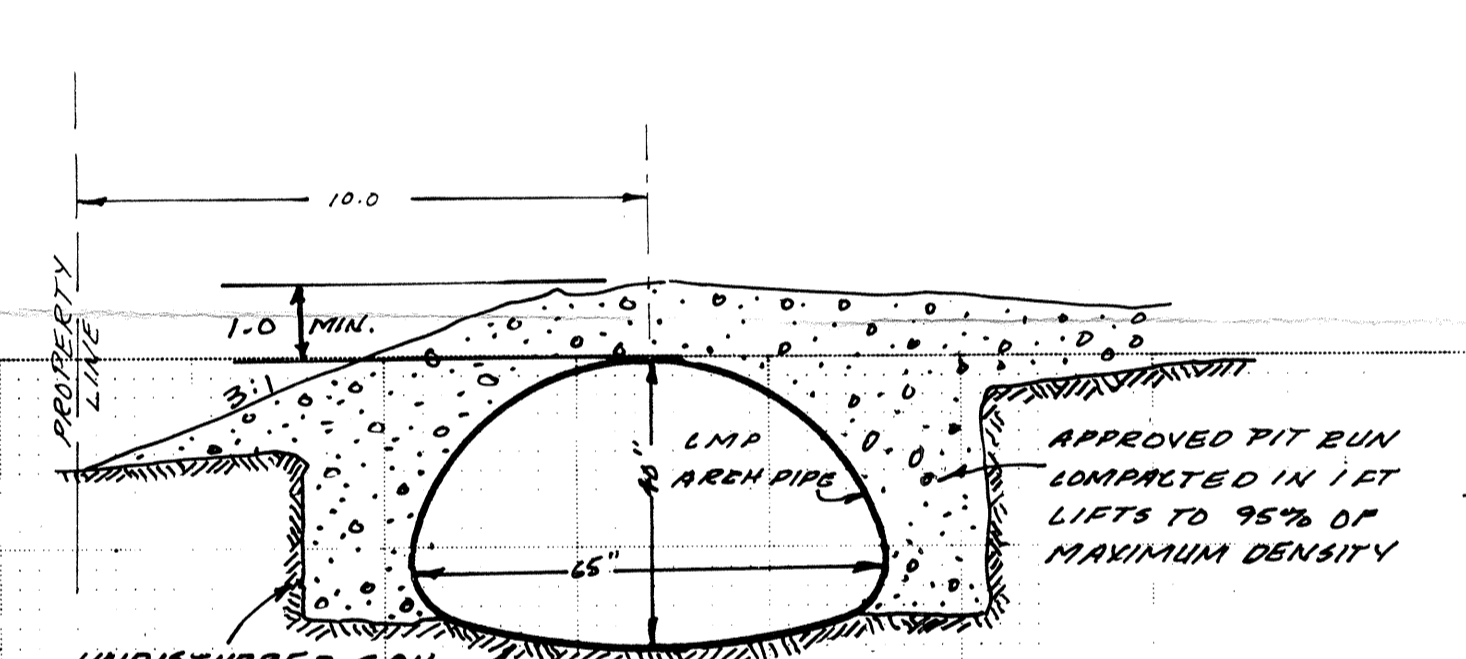


CERTIFICATION:

WE HEREBY CERTIFY THAT ALL IMPROVEMENTS ARE LOCATED AS SHOWN ON THESE AS-BUILTS



Maxwell & Meyring, P.E., P.L.C. 12/14/84 DATE
Robert Olsen 12-14-84 DATE
Dennis E. Walcker 2-25-86 DATE

No.	Revisions	Date	By	Checked
1	PER SNO. CO. PUB. WORKS	4/19/84	JRC	2/23/84
2	MOVE 1/4\"/>			
3	MOVE LOT 10/11 LINE 20' WEST; REV. LOTS 5-B PER DENNIS WALKER REQUEST	5/12/84	JRC	2/18/84
4	REVISE 4\"/>			

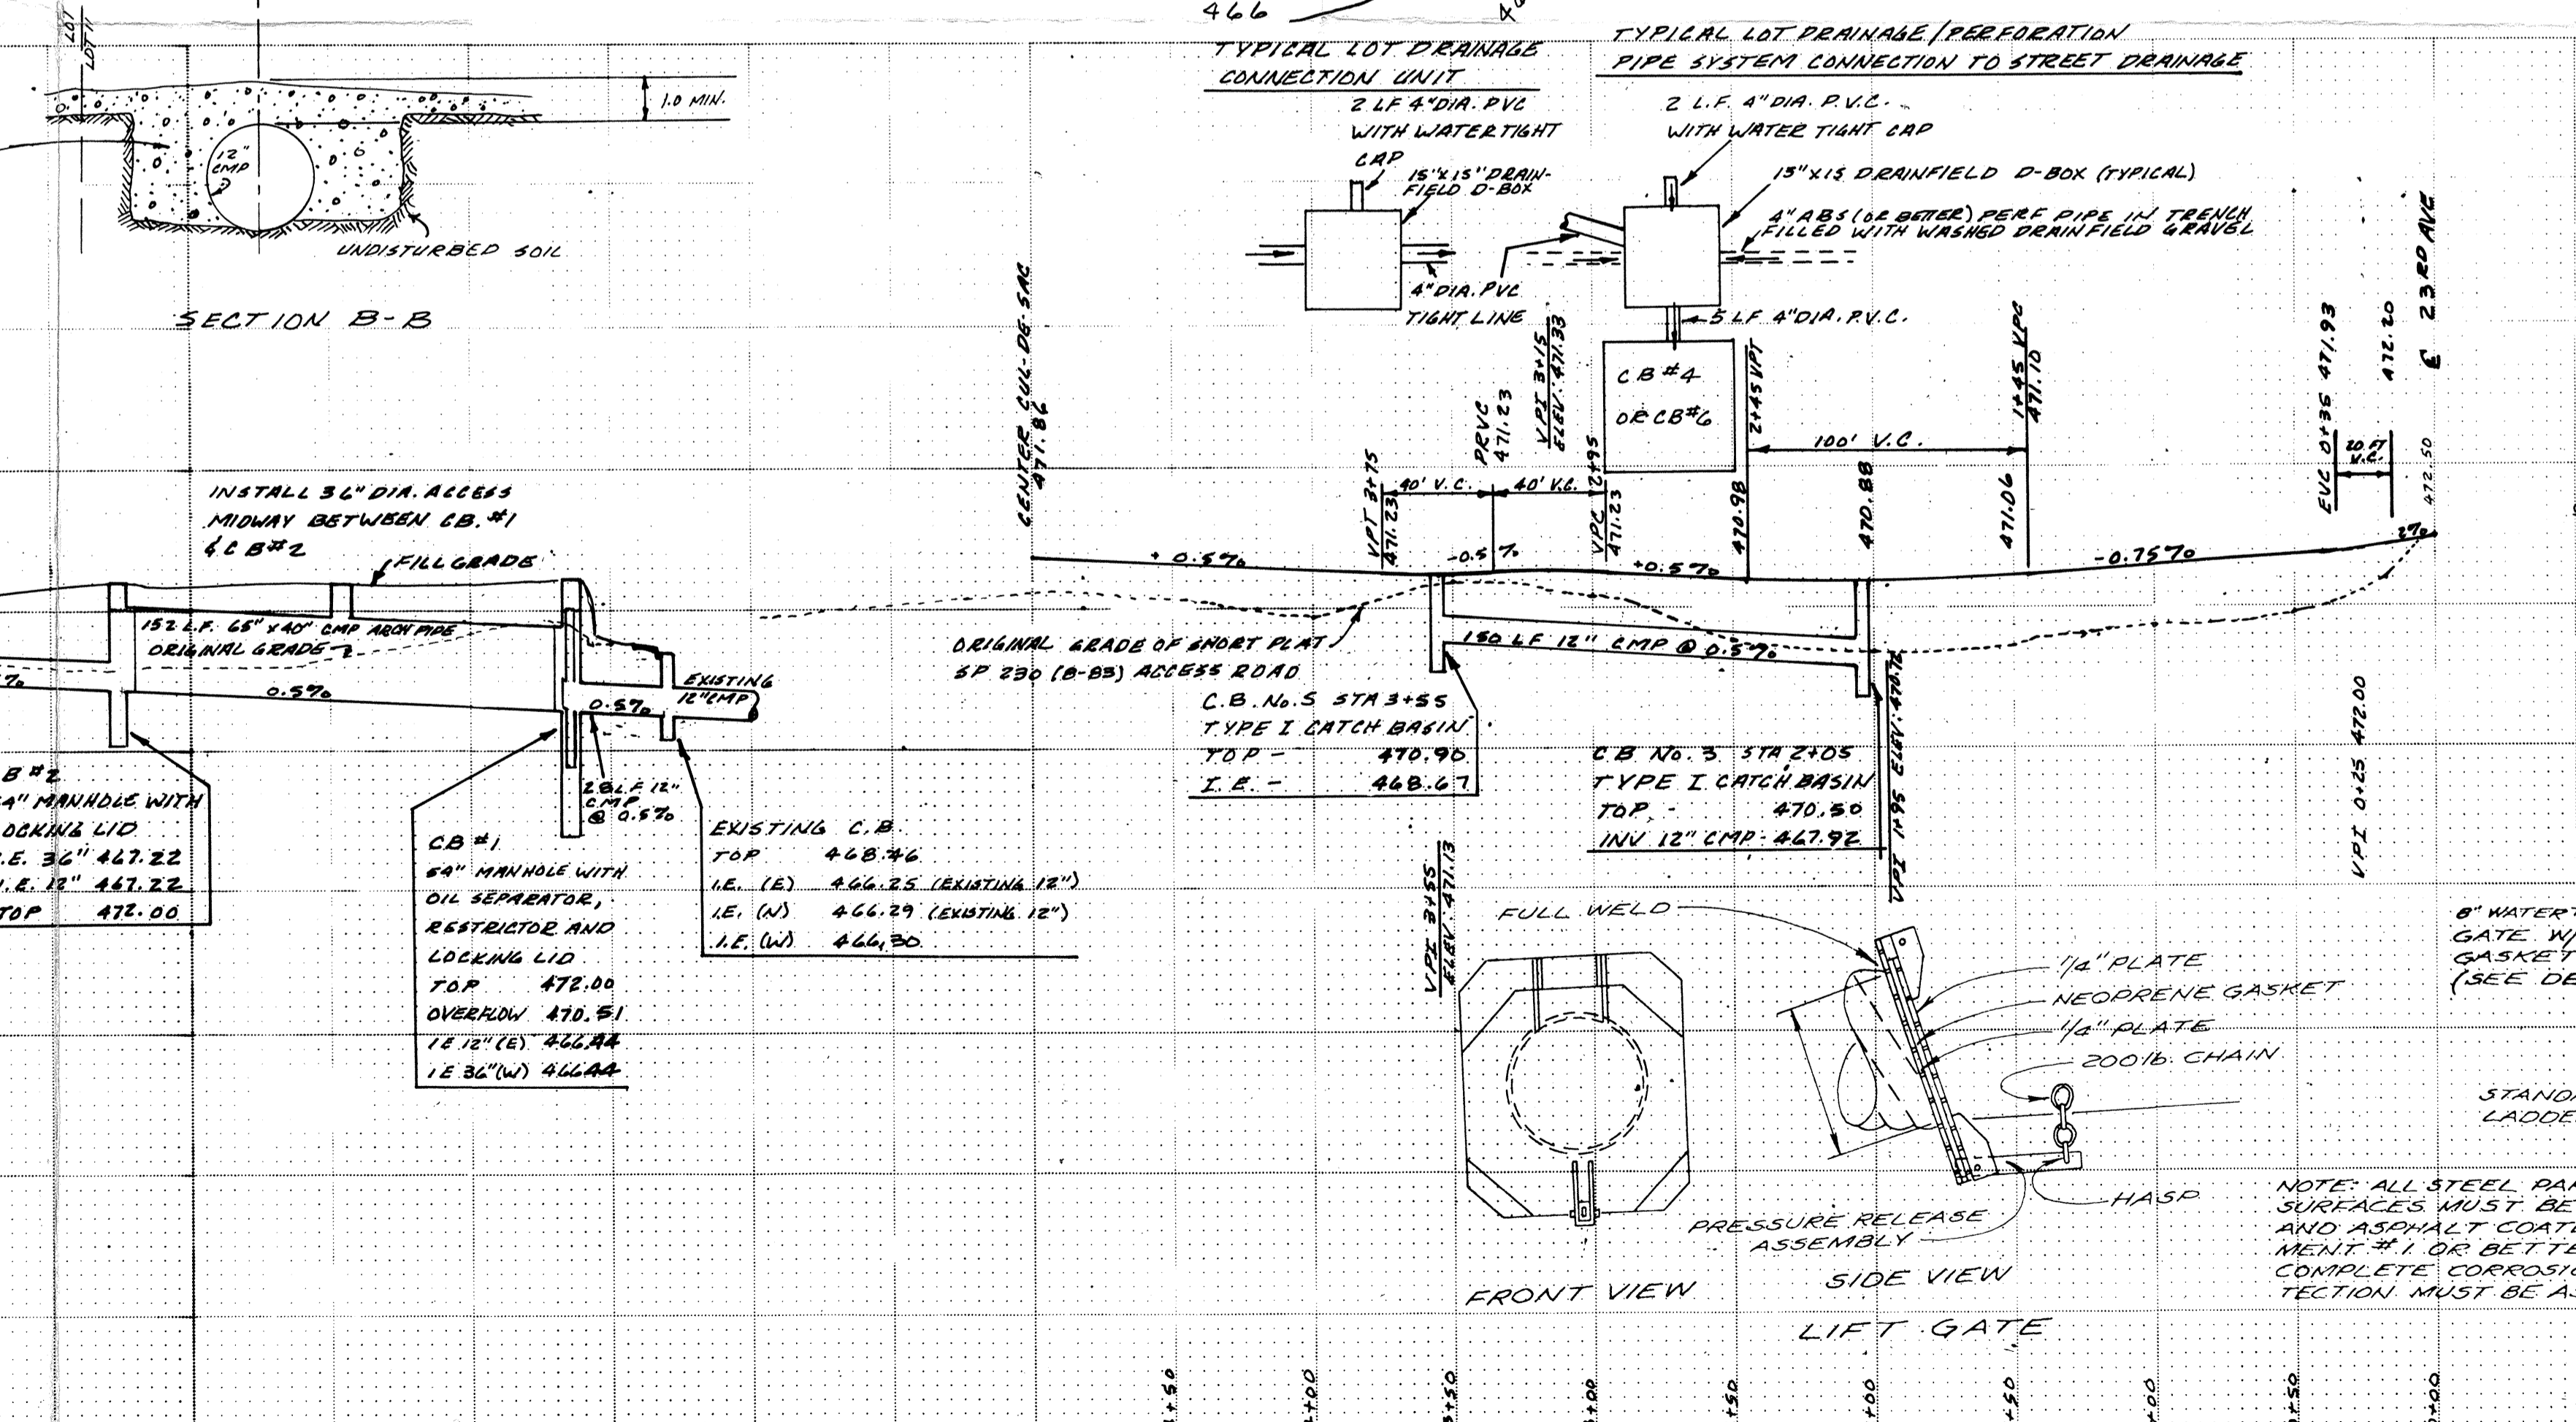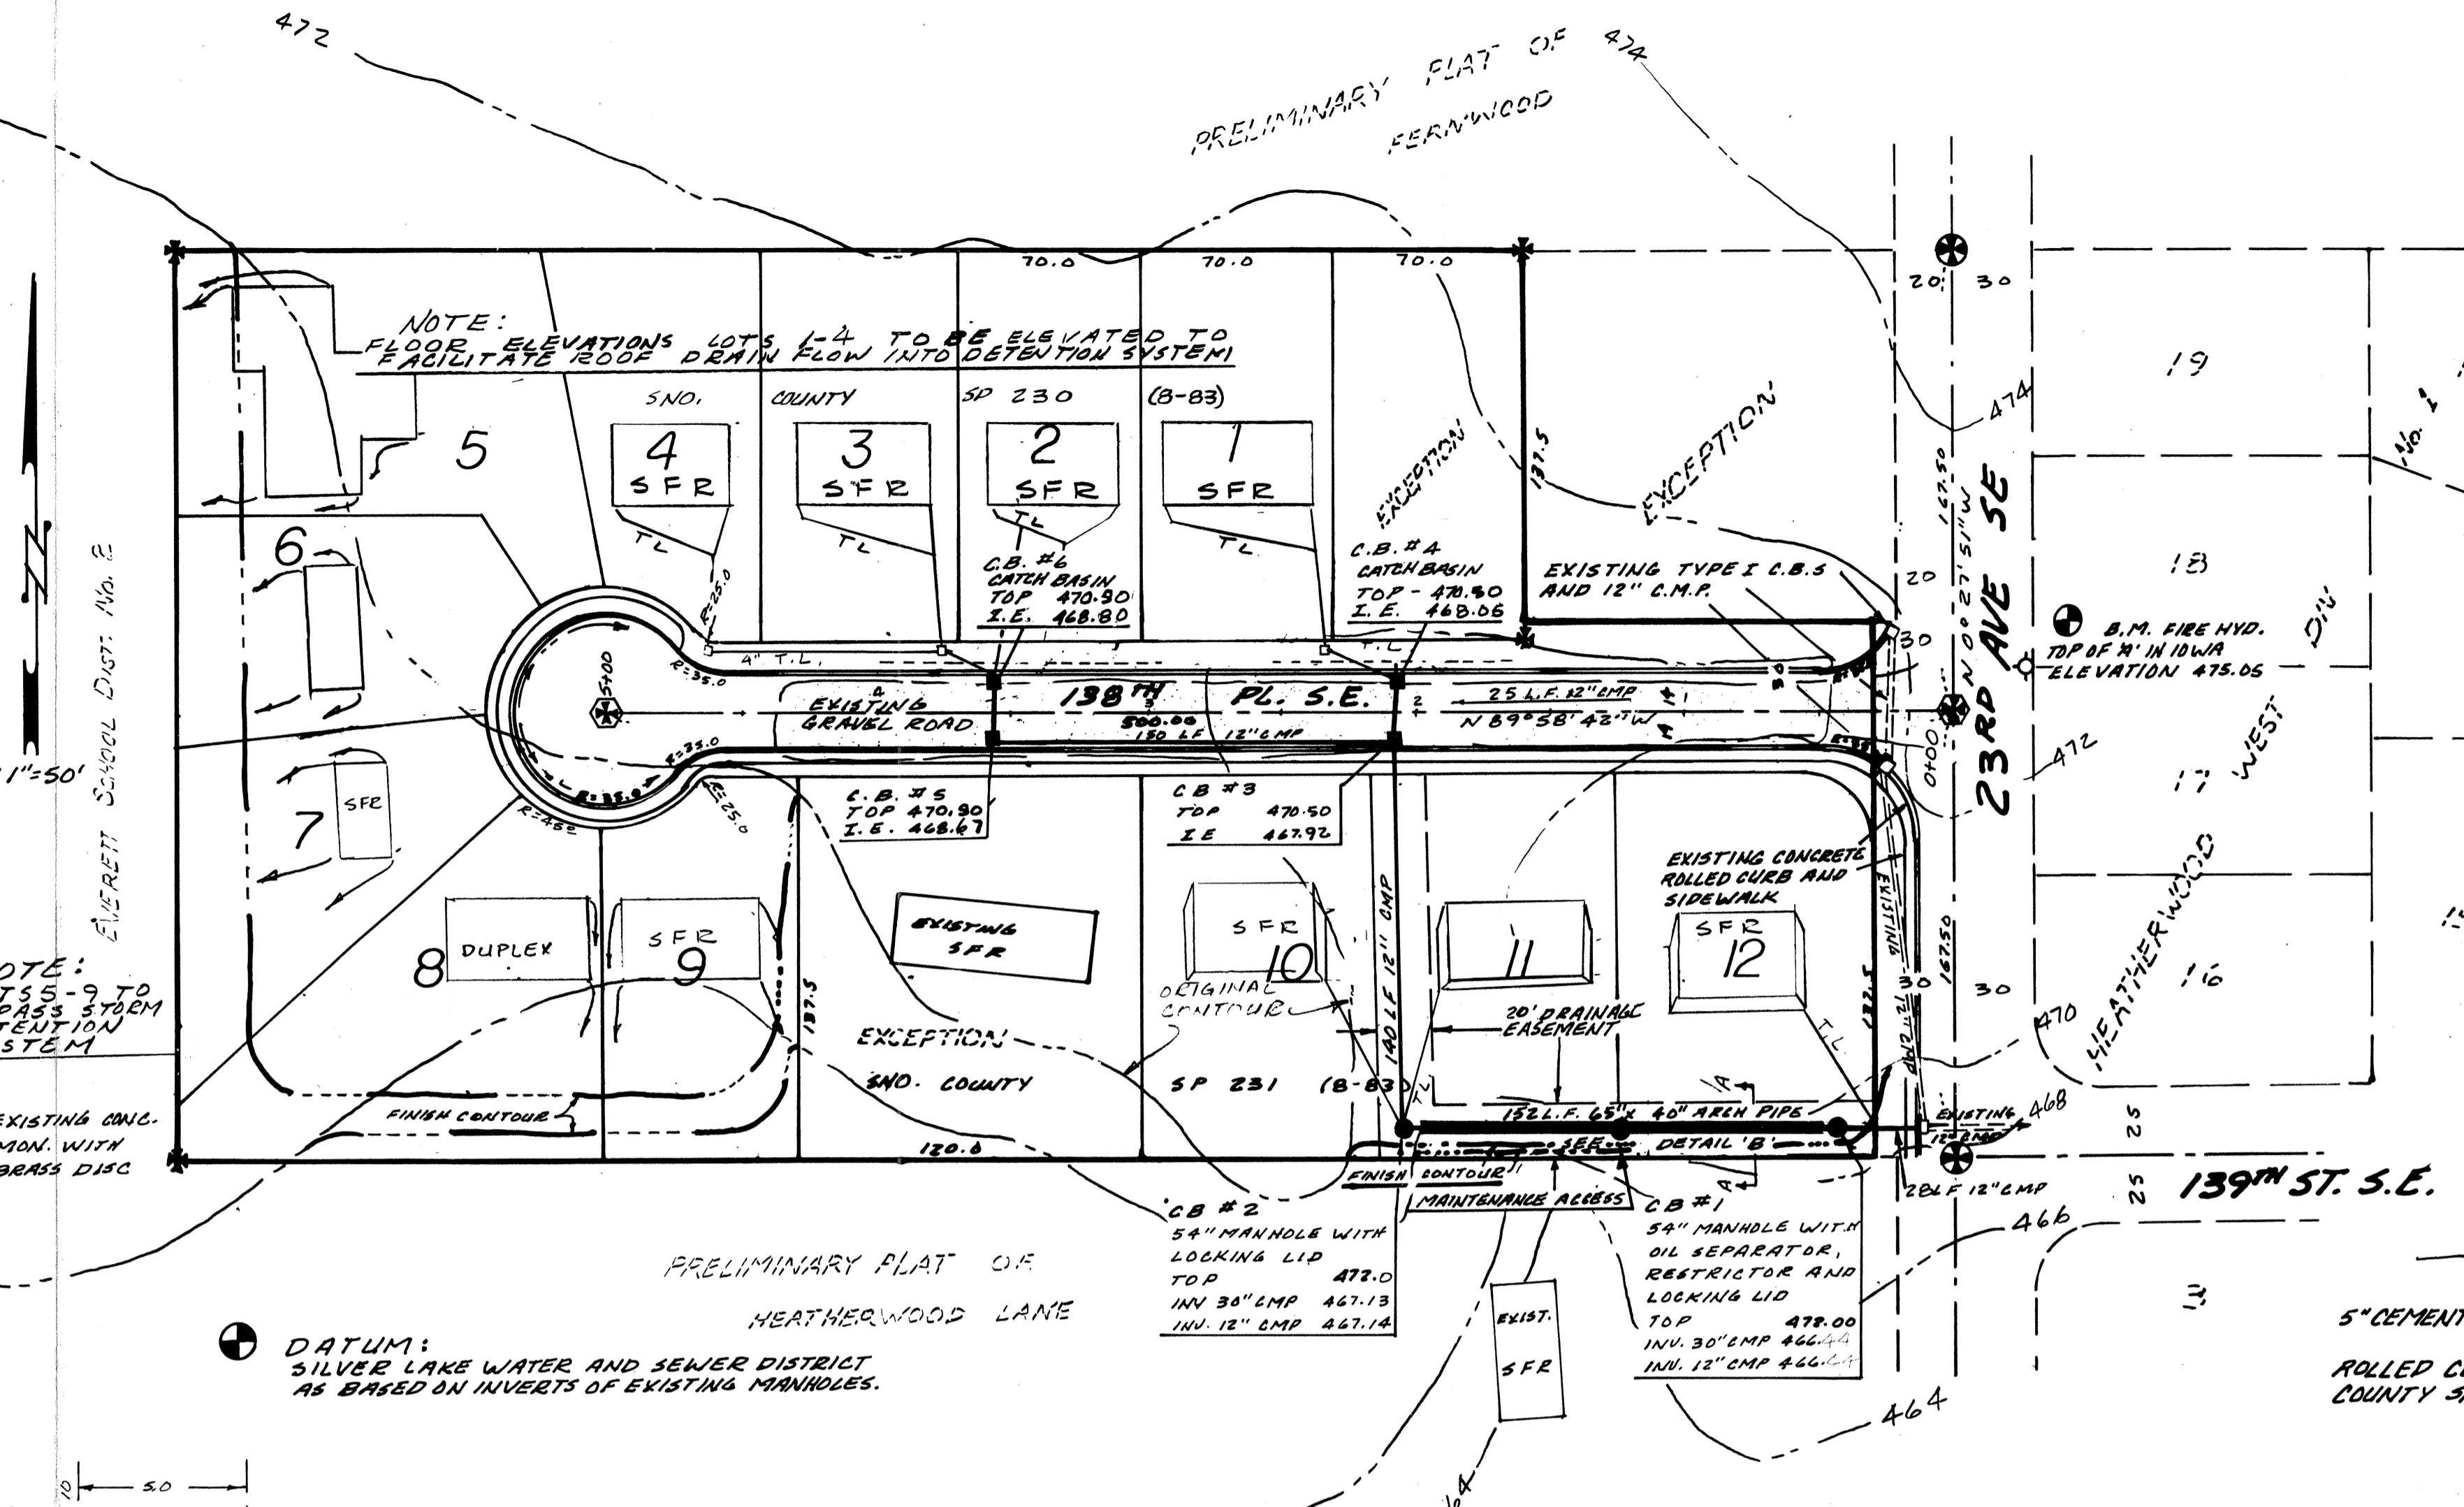

STORM DRAINAGE, ROAD PLAN AND PROFILE PLAT OF CEDAR CREST LANE AS BUILT

DESCRIPTION
 ALL OF LOT 5, B.L. HEATHERWOOD, W/80'N, 1/4\"/>

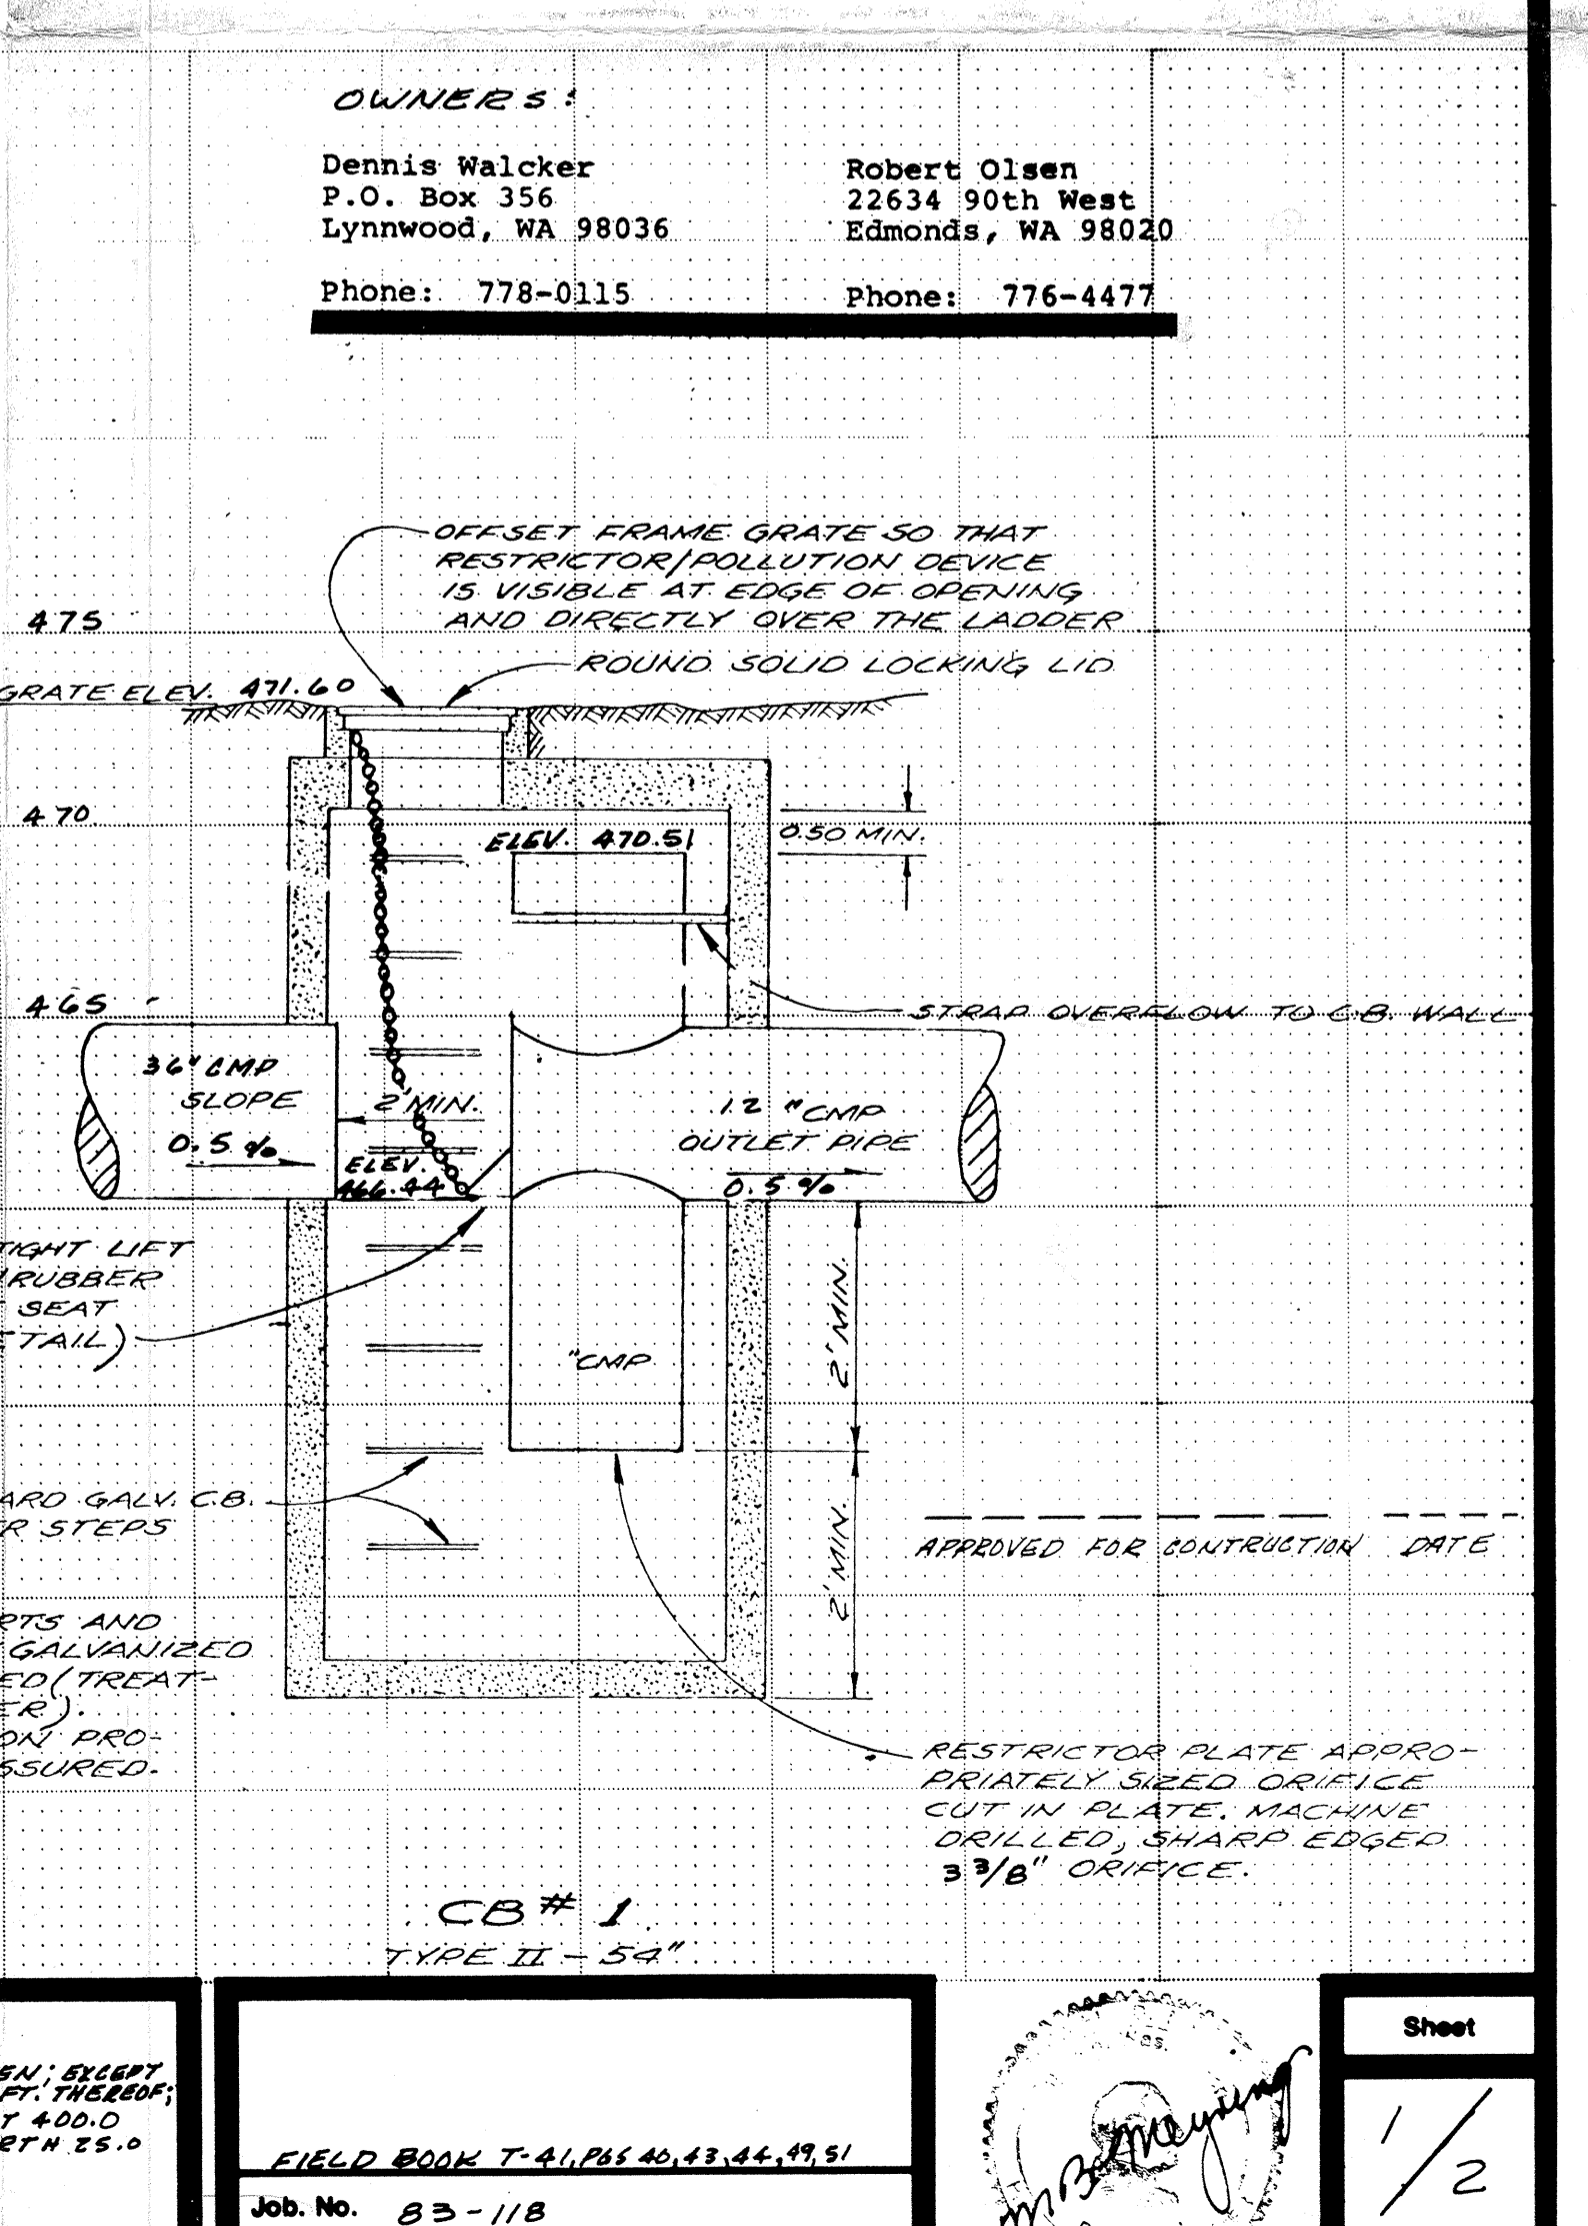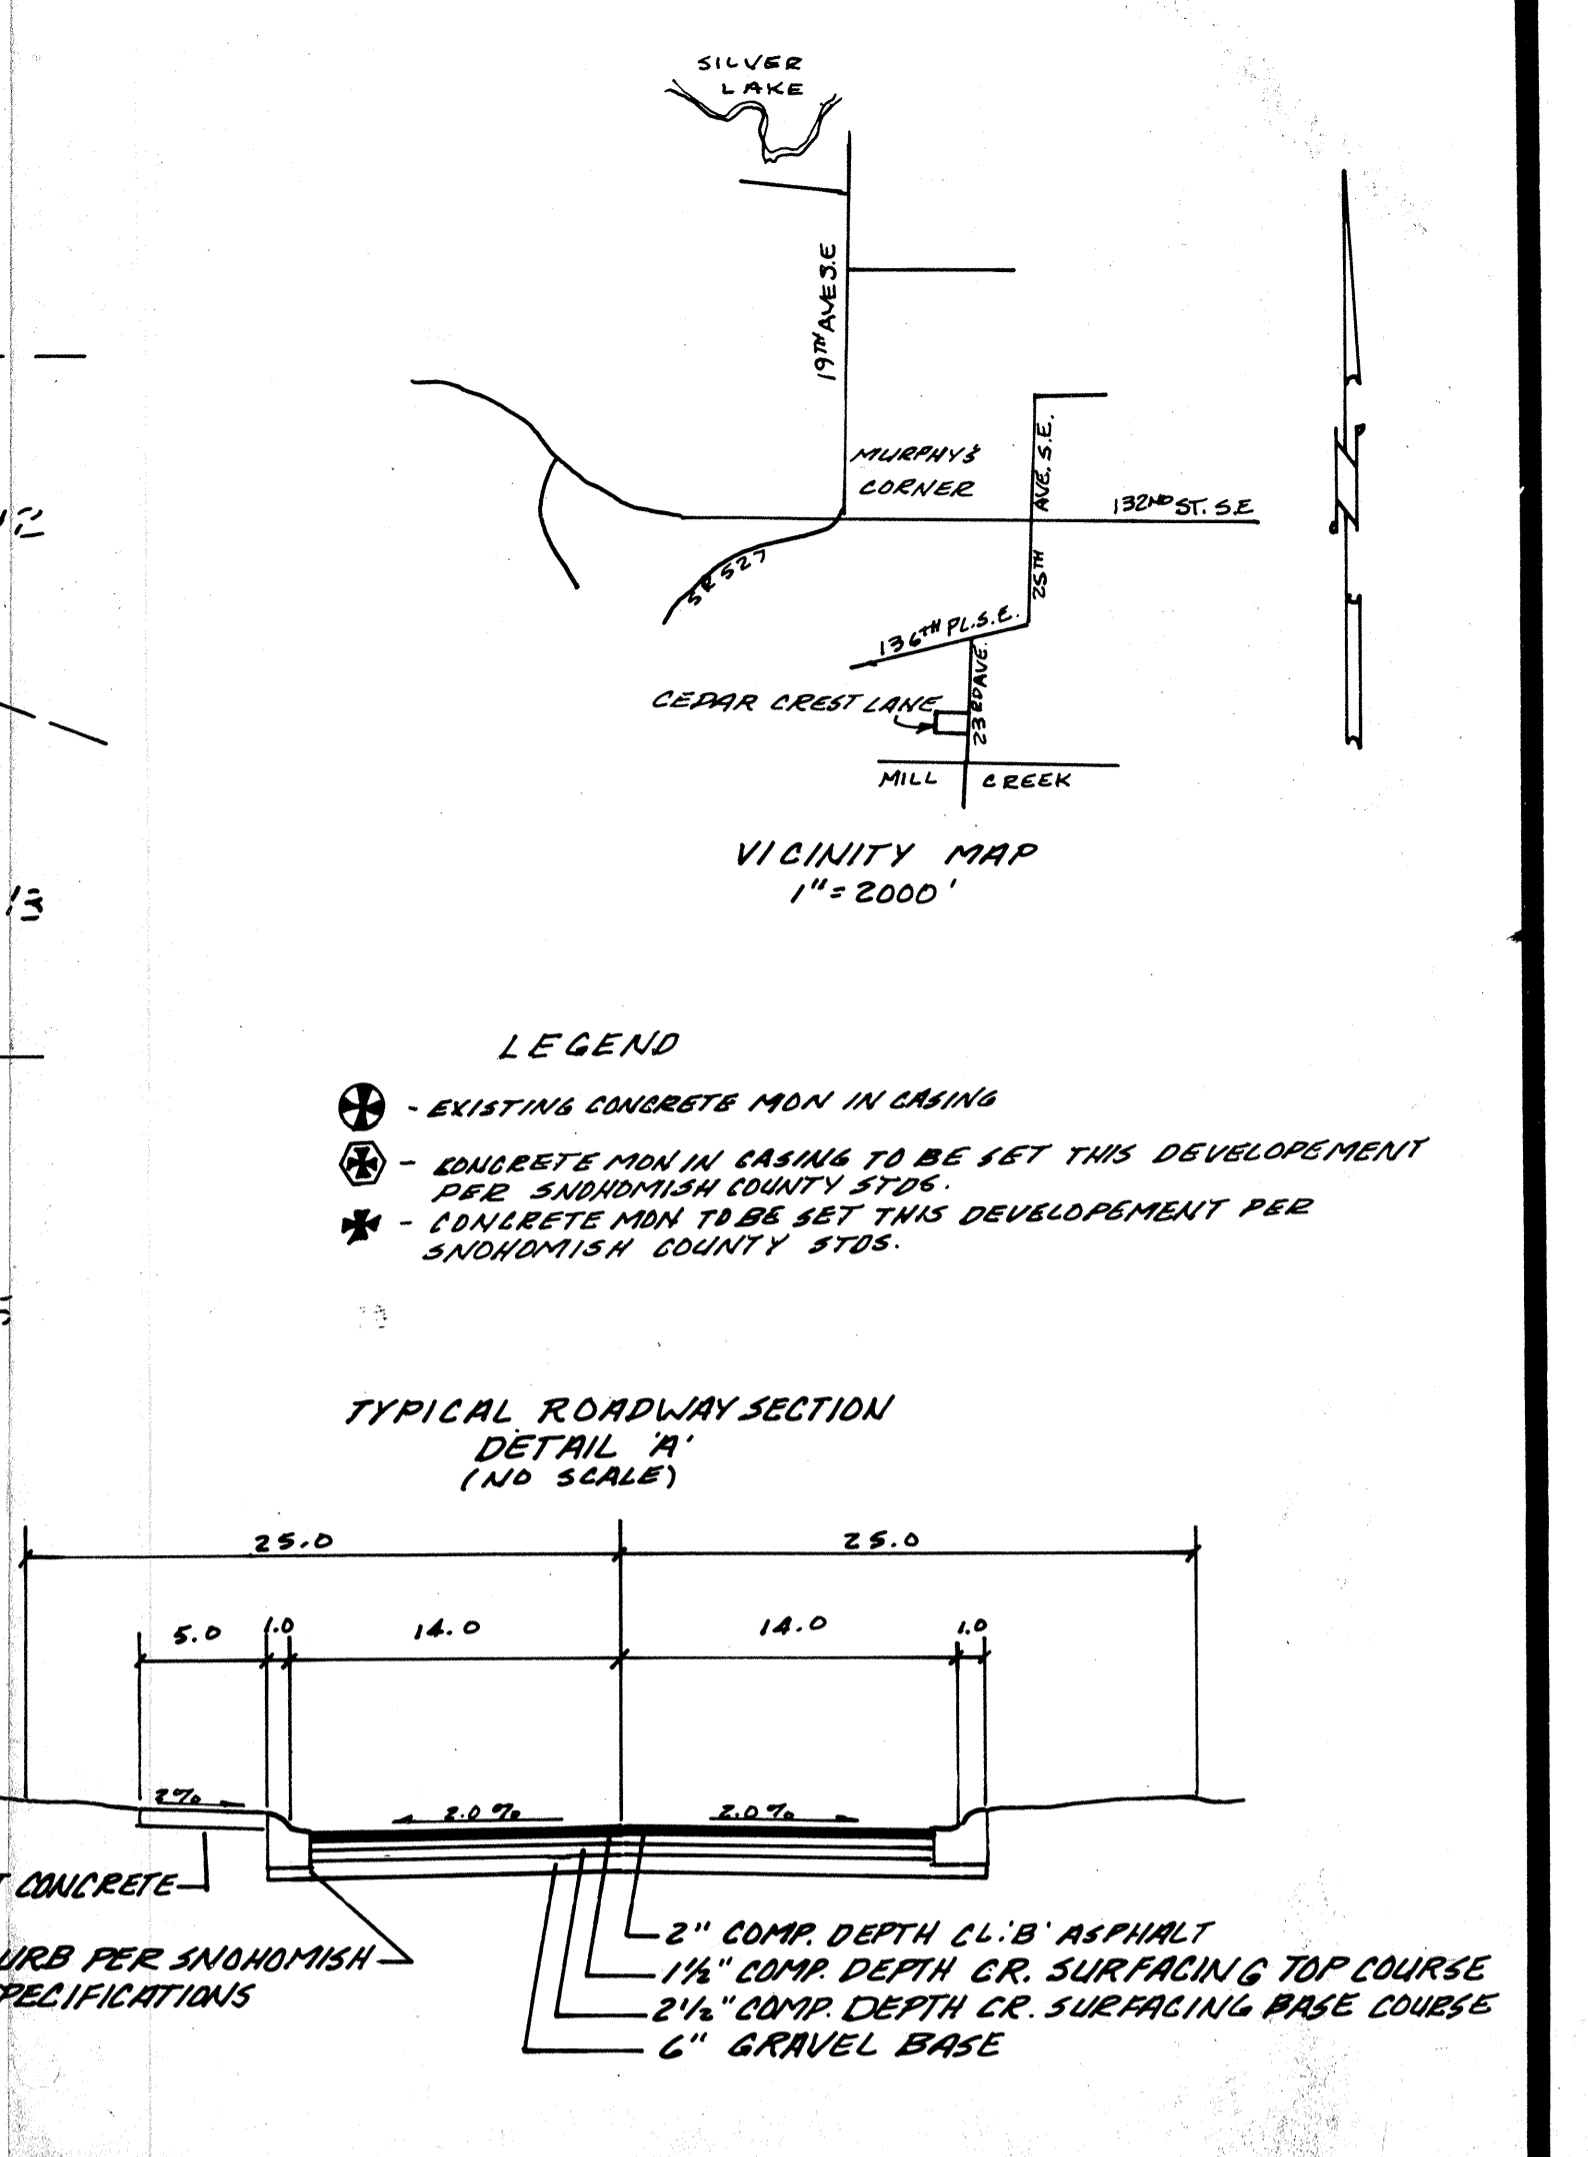

OWNERS:
 Dennis Walcker, P.O. Box 356, Lynnwood, WA 98036, Phone: 778-0115
 Robert Olsen, 22634 90th West, Edmonds, WA 98020, Phone: 776-4477

APPROVED FOR CONSTRUCTION DATE: _____

FIELD BOOK T-4, PLS NO. 43, 44, 49, 51
 Job No. 83-118

HDEV-2144 Cedar Crest Lane

CEDAR CREST LANE